


T.G. Beighan - DISCLAIMER:
 This drawing is the property of T.G. Beighan, Ltd. By accepting delivery of this drawing, the client agrees that it will not be used for any other purpose without the prior written approval of T.G. Beighan, Ltd and that all information relating to this drawing is confidential. Any discrepancies to be reported immediately.
 Materials used in conformity with relevant British or European Standards/Codes of practice or materials known to be deleterious to health are shown unless otherwise specified on this drawing.
XREFS IN THIS DRAWING

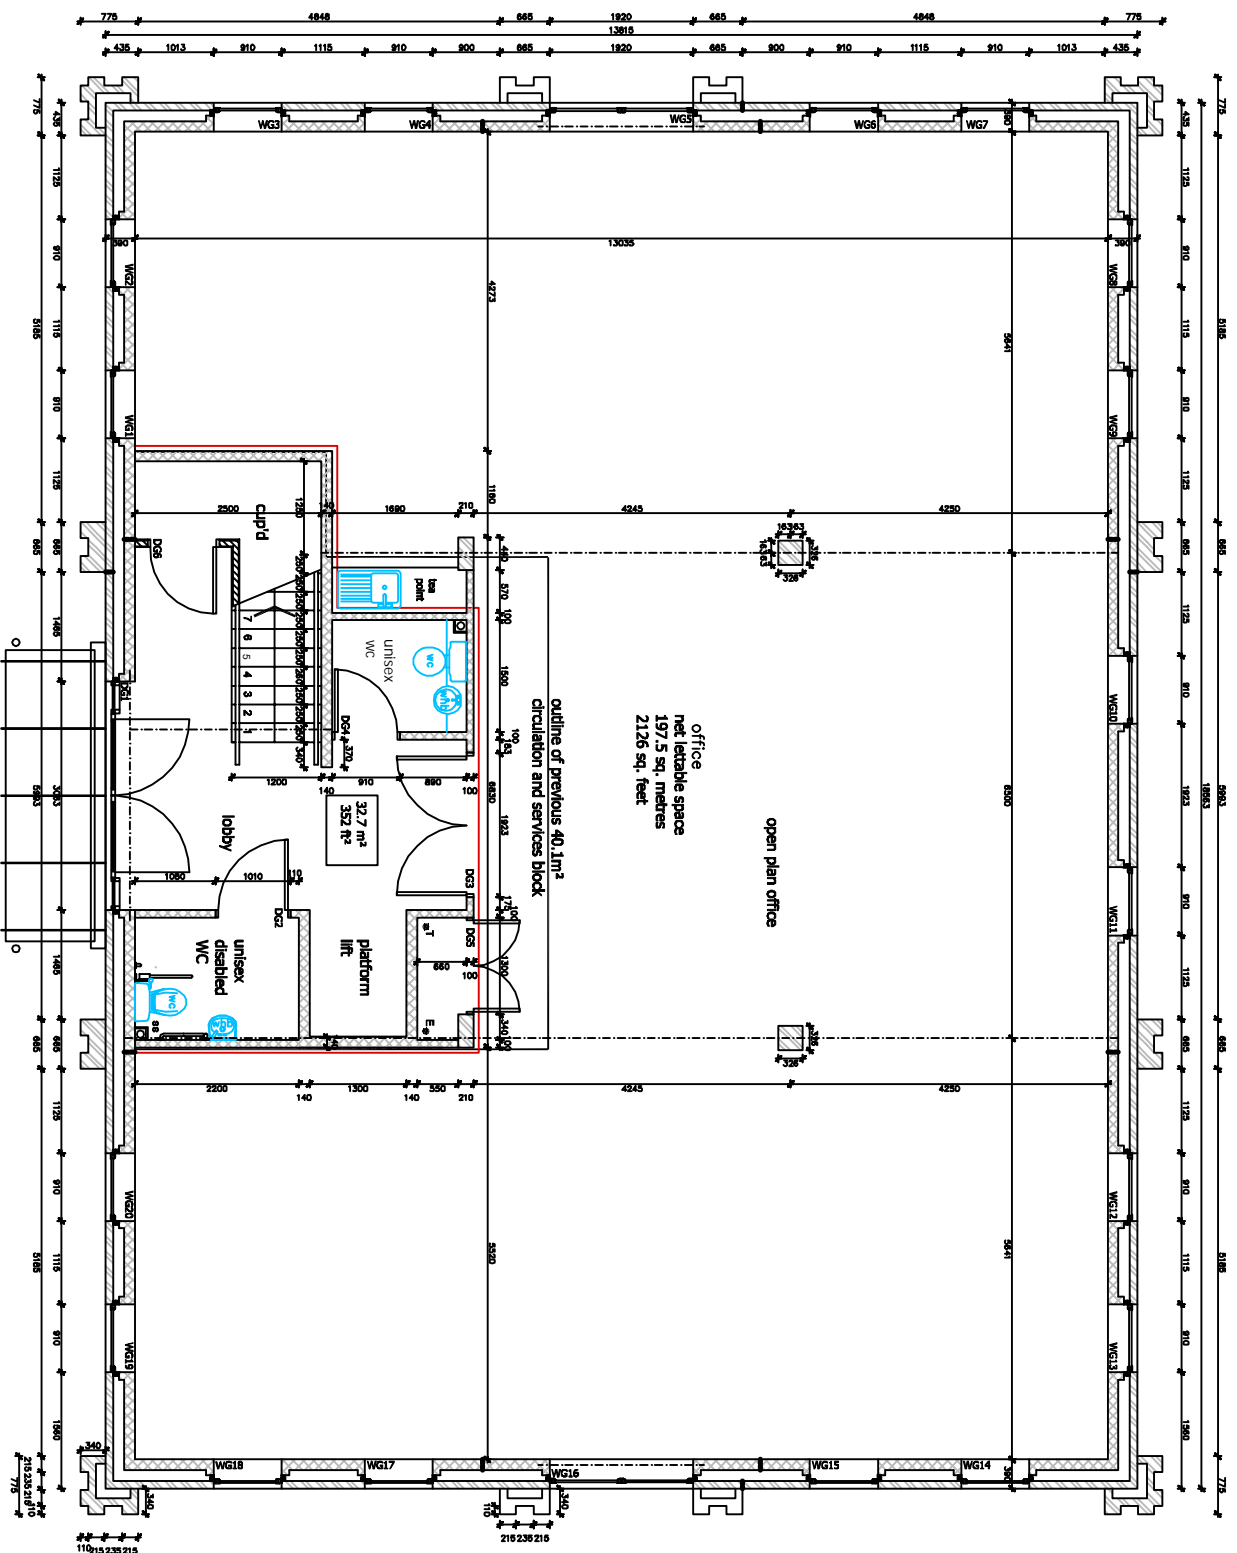

AS BUILT

CLIENT
 A Q H MICKLEGATE
 DEVELOPMENTS LIMITED

PROJECT
 OFFICE DEVELOPMENT AT
 ACRES HILL LANE

TITLE
 GROUND FLOOR PLAN
 AS PROPOSED
 Block 2 phase 2

DRAWING STATUS
 PRELIMINARY

DRAWN SJR **CHECKED**

SCALE 1:50@A1;1:100@A3

DATE 31.10.06



Helmwood, Chislehurst, Derryville, S22 8JF
 Tel: 01246 859700 Fax: 01246 859600
 enquiries@tgbgroup.co.uk
 www.tgbgroup.co.uk

JOB NO.
 8677/A/5846

DRAWING NUMBER A_02_01 **REV** A