© T.G.Beighton - DISCLAIMER:

This drawing is the property of T.G.Beighton Ltd. By accepting delivery of this drawing the recipient hereby agrees that the information contained within this drawing, in whole or in part, is confidential and proprietary to T.G.Beighton Ltd and that it will not reproduce or redistribute such drawing, discuss the information contained herein or reproductions without the prior written approval of T.G.Beighton Ltd and hold all information relating to this drawing in confidence. Any discrepancies to be reported immediately.
IF IN DOUBT ASK.
Materials not in conformity with relevant British or European Standards/Codes of practice or materials known to be deleterious to health & safety must not be used or specified on this project.

XREF'S IN THIS DRAWING

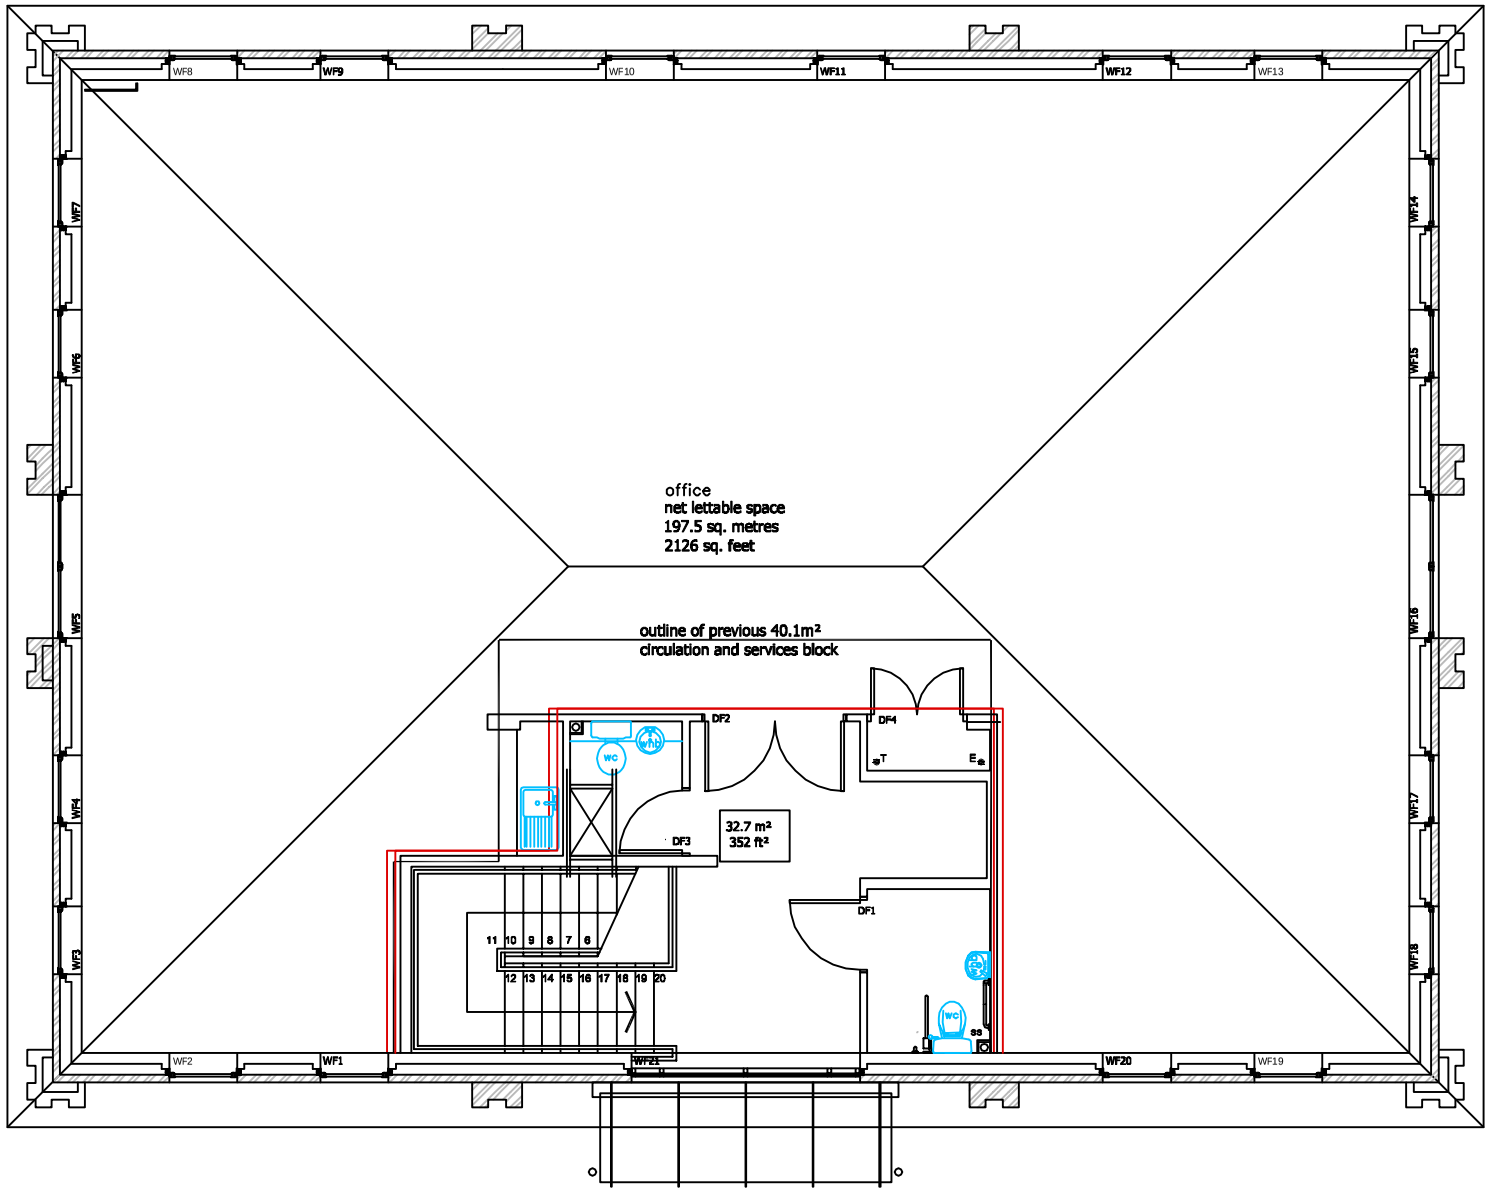

AS BUILT

A 20.11.06 cavity wall enlarged
No. | Date

CLIENT
A Q H MICKLEGATE
DEVELOPMENTS LIMITED

PROJECT
OFFICE DEVELOPMENT AT
ACRES HILL LANE

TITLE
FIRST FLOOR PLAN
AS PROPOSED
BLOCK 2 phase 2

DRAWING STATUS
PRELIMINARY

DRAWN	SJR	CHECKED
SCALE	1:50@A1,1:100@A3	
DATE	31.10.06	

TGB
CONSTRUCTING FUTURES

Holmewood Chesterfield Derbyshire S42 5RF
Tel: 01246 859700 Fax: 01246 859600
enquiries@tgbeighton.co.uk
www.tgbeighton.co.uk

JOB NO.
867/A/5846

DRAWING NUMBER	REV
A_02_02	A